

**DEPARTMENT OF CIVIL AVIATION
SIR SEEWOOSAGUR RAMGOOLAM INTERNATIONAL AIRPORT
PLAINE MAGNIEN
REPUBLIC OF MAURITIUS
Tel: (230) 603 2000
Fax: (230) 637 3164
Email: civil-aviation@govmu.org**

ADDENDUM No 1

Dear All,

**Consultancy Services for the Replacement of the Chiller Plant System at the
Area Control Centre (ACC) for the Department of Civil Aviation**

CAV/QUO/NO. 12 OF 2025-26

Query 1

Quote

Further to the pre-bid visit on Monday 26/01/2026, we would be grateful if you could forward us dimensioned layouts of the ground and first floors.

Unquote

Answer 1

The dimensioned layouts for the Area Control Centre is given at Annex 1.

Query 2

Quote

Further to the pre-proposal conference meeting held on 26 January 2026, we would be grateful if you could kindly provide clarification on the following points:

- Confirmation of the overall project value
- Availability of any existing as-built drawings

Unquote

Answer 2

As per Paragraph B, Section V, Terms of Reference of the bidding documents, the cost estimate for the supply, installation, testing, and commissioning of the new HVAC system has to be provided by the consultant. No as-built drawing for the current HVAC system is available.

Query 3

Quote

We note that the Consultancy services and subsequent works required are purely Mechanical & Electrical ones, so we would be grateful if you could clarify the requirements for "Architect" and "Quantity Surveyor" as per Item 3.3(b) and Item 5.2 (iii) (d) & (e) in the Instructions to Consultants – Data Sheet.

Unquote

Answer 3

The services of a qualified Architect will be required to address all architectural matters arising during the implementation of the project. The Architect shall be responsible for preparing accurate, scaled architectural drawings, including plans, sections, and elevations, as required for the execution of the works.

The project will necessitate the dismantling, removal, and subsequent reinstatement of the existing false ceiling to facilitate the installation of the new Chiller Plant System. In the event that the false ceiling is damaged during removal, the Architect may be required to develop an appropriate design for its replacement or reinstatement.


The Architect shall also be responsible for addressing any other architectural matters related to the project as may arise during its implementation.

On the other hand, the services of a qualified Quantity Surveyor (QS) will be required to address payment matters, manage contractual issues including extension of time, variation works and liquidated damages, as well as handle insurance and other QS-related matters.



A BOOJHAWON (Mrs)
for Ag Director of Civil Aviation

encl.

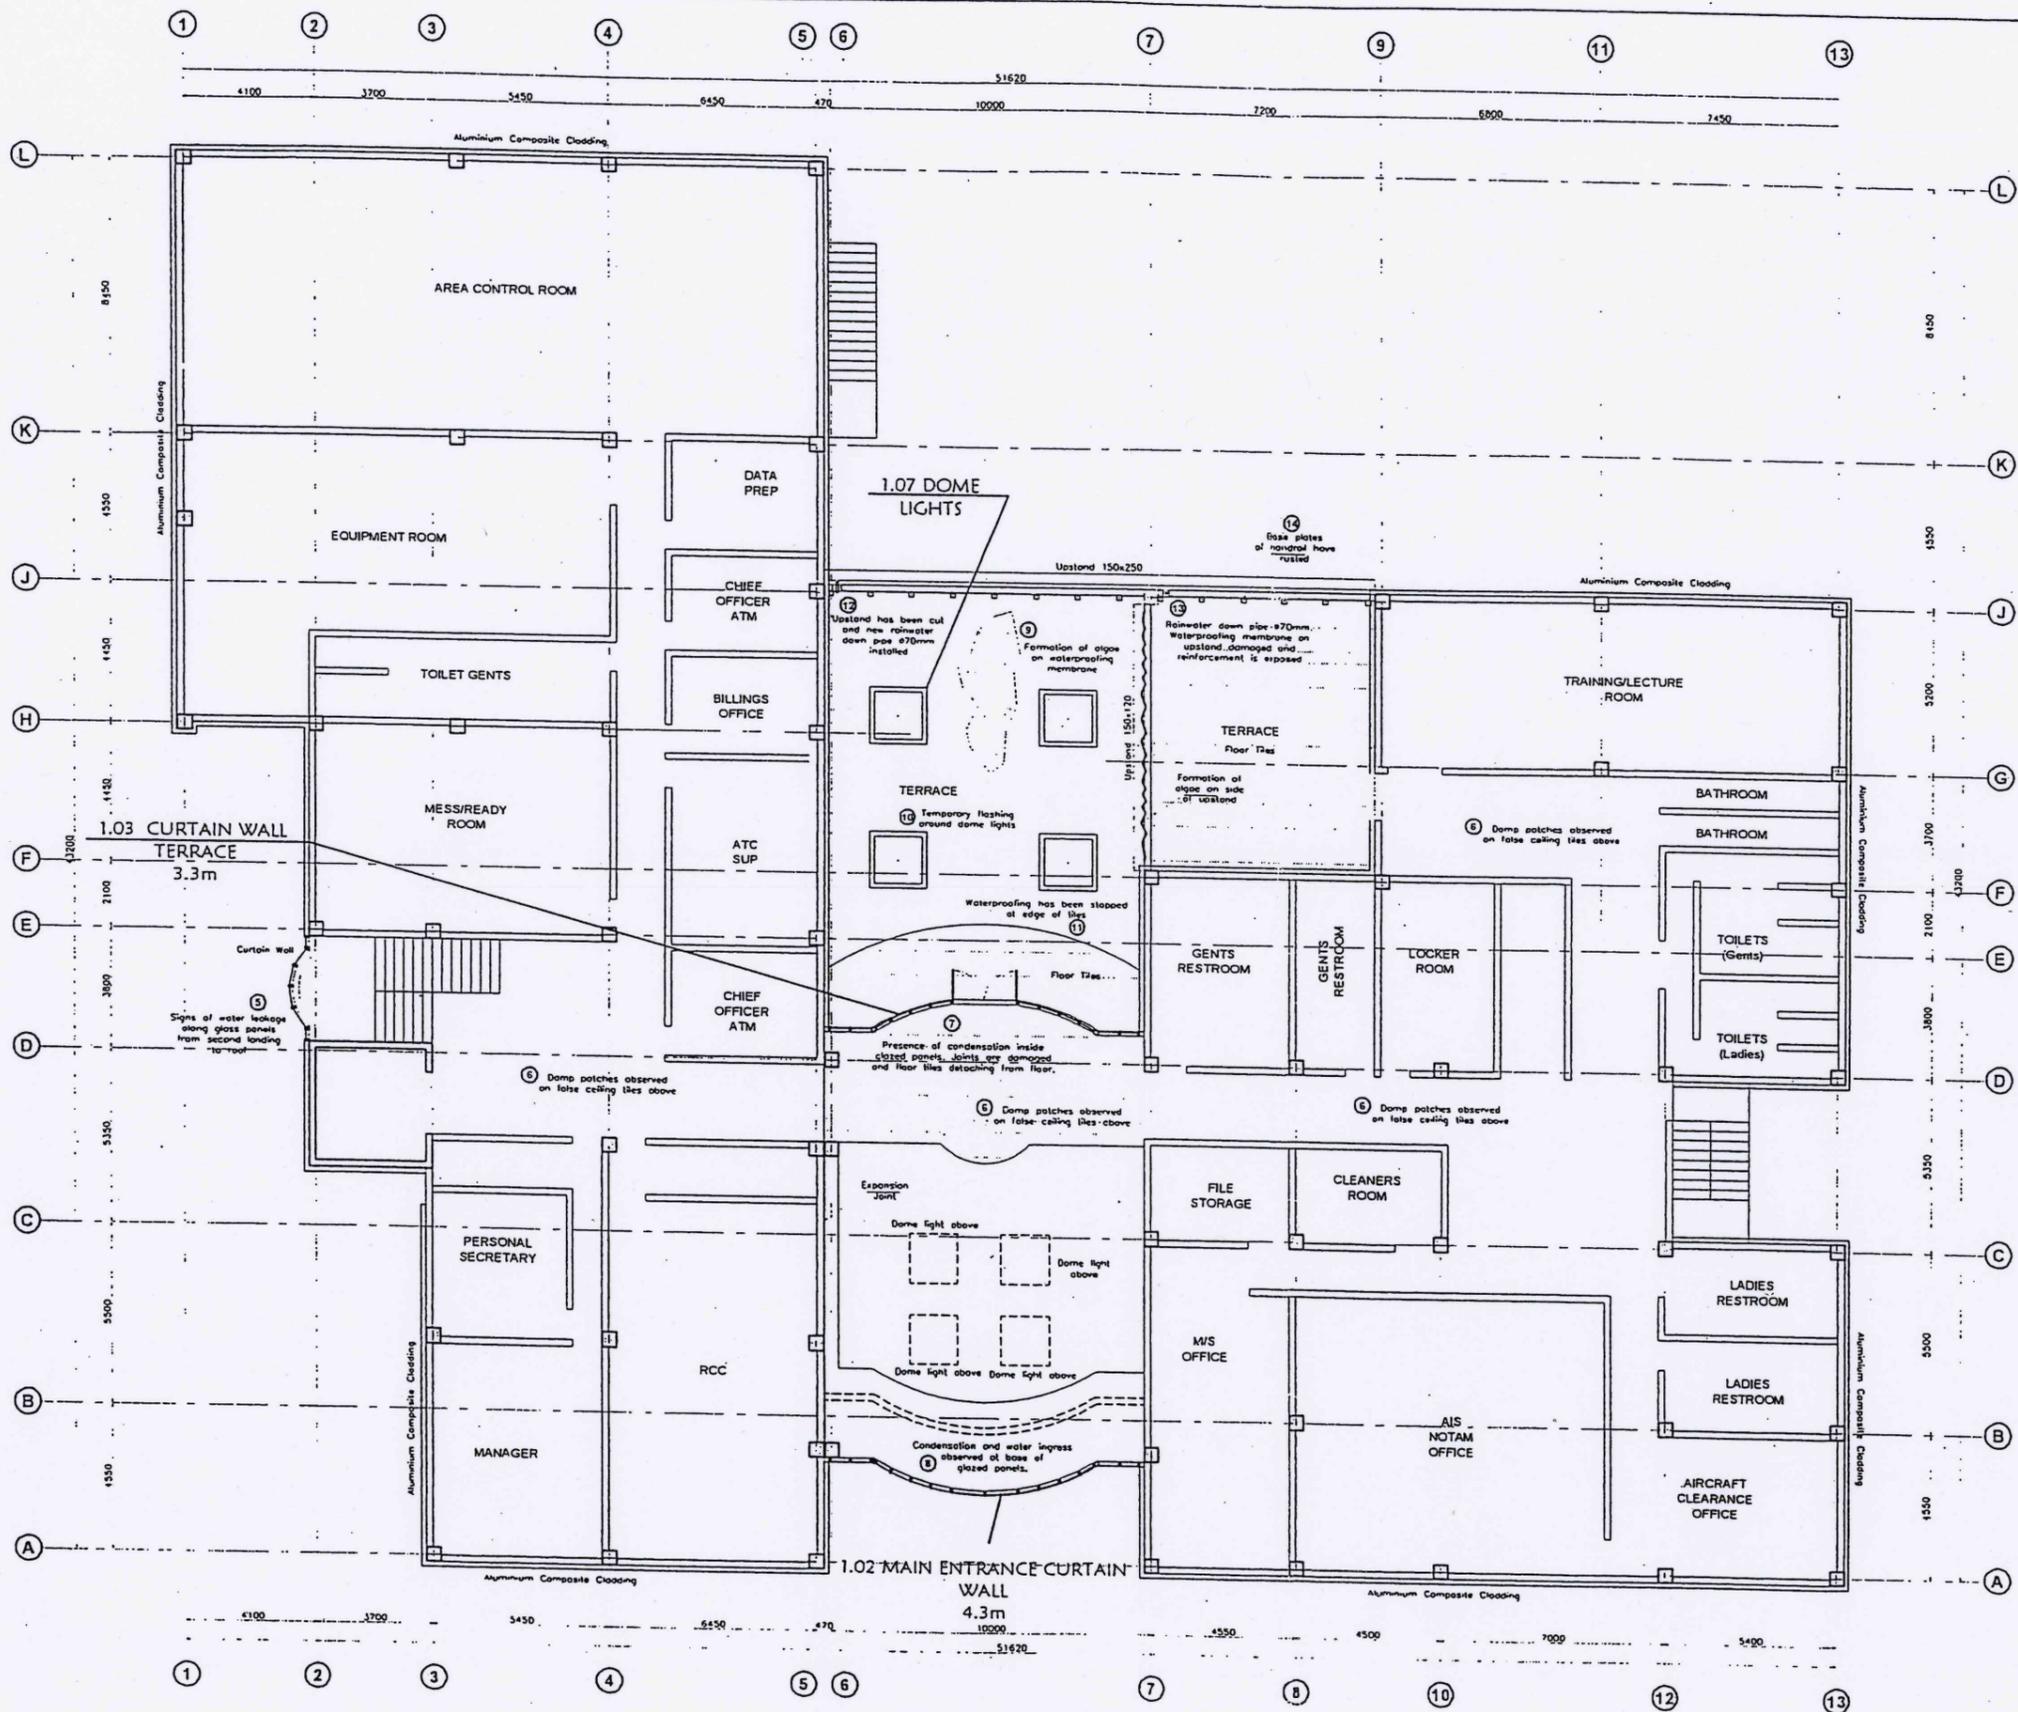


This document and its contents are the copyright of the designer. Any party receiving this document does so in confidence & agrees that all the information contained therein shall not be published in whole or in part or disclosed to others without the prior written consent of FWA ARCHITECTS.

- ALL DIMENSIONS TO BE VERIFIED ON SITE PRIOR TO CONSTRUCTION.
- ANY DISCREPANCY TO BE IMMEDIATELY REPORTED TO THE ARCHITECT.
- USE FIGURED DIMENSIONS, DO NOT SCALE.
- THIS DRAWING IS NOT FOR CONSTRUCTION, UNLESS SPECIFICALLY STATED.
- THIS DRAWING SHOULD BE READ JOINTLY WITH ALL RELEVANT ENGINEERS' DRAWINGS.

Rev.	Description	By

FRANCIS WONG ASSOCIATES LTD

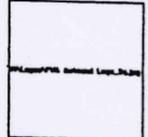

51, Trotter Street, Beau-Bassin, Mauritius
 Tel +230 465 0858 / +230 466 0959
 Fax +230 465 0441
 Email fwa@fwarchitects.net
 VAT 20176138 BRN C06021121


PROJECT
 Refurbishment of Area Control Centre at Plaine Magnien

CLIENT
 Department of Civil Aviation

Project No. AAC

DRAWING TITLE
 REFERENCE
 PLAN First Floor

Dwg No. 2.0	REV.
DRAWN BY DS	SCALE 1:200
CHECKED BY GA	25.07.19

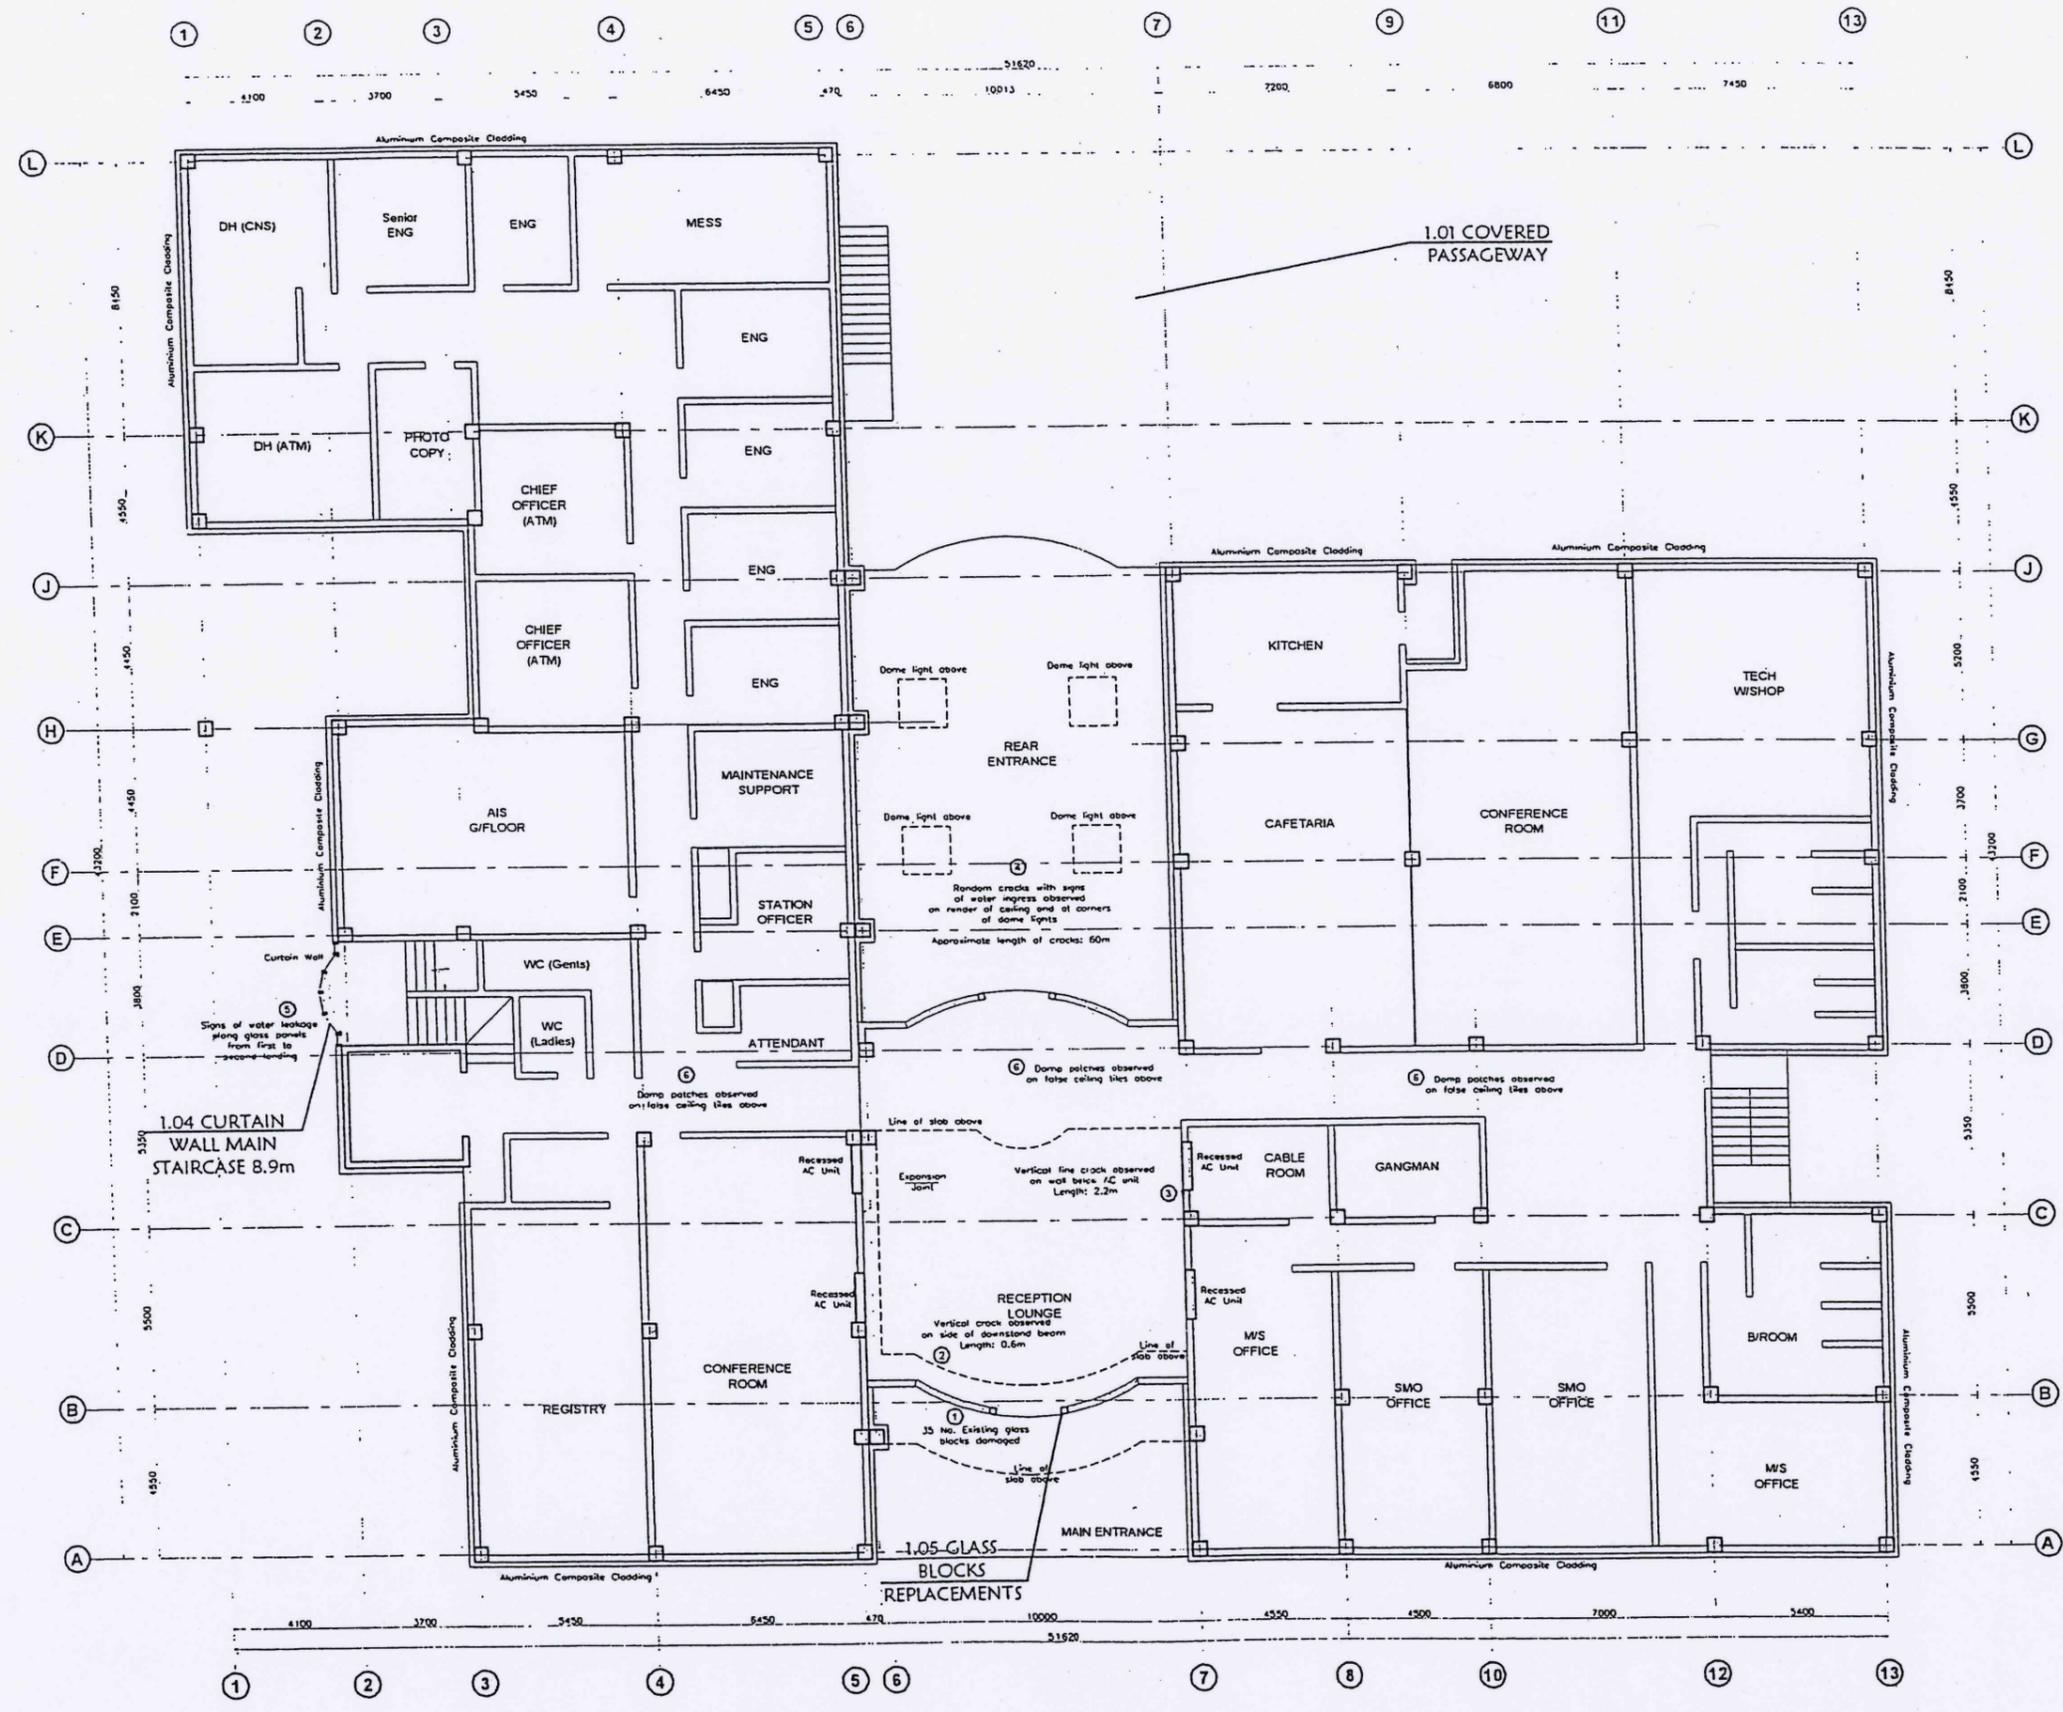

This document and its contents are the copyright of the designer. Any party receiving this document does so in confidence & agrees that all the information contained therein shall not be published in whole or in part or disclosed to others without the prior written consent of FWA ARCHITECTS.

- ALL DIMENSIONS TO BE VERIFIED ON SITE PRIOR TO CONSTRUCTION.
- ANY DISCREPANCY TO BE IMMEDIATELY REPORTED TO THE ARCHITECT.
- USE FIGURED DIMENSIONS. DO NOT SCALE.
- THIS DRAWING IS NOT FOR CONSTRUCTION. UNLESS SPECIFICALLY STATED.
- THIS DRAWING SHOULD BE READ JOINTLY WITH ALL RELEVANT ENGINEERS DRAWINGS.

Rev.	Description	By

FRANCIS WONG ASSOCIATES LTD

51, Trotter Street, Beau-Bassin, Mauritius
 Tel +230 465 0858 / +230 466 0959
 Fax +230 465 0441
 Email fwa@fwarchitects.net
 VAT 20176138 BRN C06021121

PROJECT
 Refurbishment of Area Control Centre at Plaine Magnien

CLIENT
 Department of Civil Aviation

Project No. AAC

DRAWING TITLE
 REFERENCE
 PLAN Ground Floor

Dwg No. 1.0	REV.
DRAWN BY DS	SCALE 1:200
CHECKED BY GA	25.07.19